

ANCHORAGE, ALASKA

AR No. 2019-133

A RESOLUTION OF THE ANCHORAGE MUNICIPAL ASSEMBLY STATING ITS PROTEST REGARDING A NEW RESTAURANT/EATING PLACE LIQUOR LICENSE, #5758, AND RESTAURANT DESIGNATION PERMIT, FOR SPOONS, LLC DBA SPOONLINE LOCATED AT 174 HIGHTOWER RD., GIRDWOOD, AK 99587 AND AUTHORIZING THE MUNICIPAL CLERK TO TAKE CERTAIN ACTION.

(Girdwood Community Council)

WHEREAS, Spoons, LLC has made an application with the Alaska Alcohol and Marijuana Control Office (AMCO), for consideration by the Alcoholic Beverage Control (ABC) Board, and has paid the required fee for a new restaurant/eating place liquor license, #5758, and restaurant designation permit, to be used for Spoonline located at 174 Hightower Rd., Girdwood, Alaska, 99587; and

WHEREAS, the Assembly must enter any protest to AMCO within 60 days following receipt of the application; and

WHEREAS, Anchorage Municipal Code (AMC) 2.30.120 and 3 AAC 304.145(d) require the Assembly to hold a public hearing to provide the applicant an opportunity to defend their application prior to exercising or waiving the right to protest; and

WHEREAS, the Anchorage Municipal Clerk received a copy of this application on March 19, 2019 and has determined that the last day for the Assembly to file a protest is May 18, 2019; and

WHEREAS, this resolution sets the public hearing on the protest of a new restaurant/eating place liquor license, #5758, for April 23, 2019; and

WHEREAS, 10 day notice of the public hearing has been given to the applicant and the Girdwood Community Council as required by AMC 2.30.120. and AS 04.21.010(d); and

WHEREAS, the Assembly Meeting on May 7, 2019 is the last scheduled regular meeting of the Anchorage Assembly prior to the expiration of the protest period; and

WHEREAS, the Municipal Clerk reports the following status concerning this location:

1. Any ABC Board violations and/or incidents on file that would lead to an ABC Board violation are attached; and
2. There are no taxes owing to the Municipality of Anchorage; and
3. Special Land Use Permit, required by AMC 21.03.040C4.b., **has not been approved**; and

- 1
2 4. Certification from the State of Alaska Fire Marshal **has not been received**; and
3
4 5. Certification from the Department of Health and Human Services **has not been**
5 **received**; and
6

7 **WHEREAS**, protest by the Assembly is in order pending Assembly confirmation that
8 outstanding items required for this location have been completed.
9

10 **NOW, THEREFORE**, the Anchorage Assembly resolves:
11

12 **Section 1.** The Anchorage Assembly hereby enters its **PROTEST** for a new
13 restaurant/eating place liquor license, #5758, until these conditions are
14 met:
15

- 16 • Special land use permit as required by AMC 21.03.040C.4.a has
17 been approved by the Assembly.
- 18 • Certifications from the State of Alaska Fire Marshal and from the
19 Department of Health & Human Services has been received.
20

21 **Section 2.** A copy of this Assembly Resolution may be presented to AMCO as proof
22 that the Anchorage Assembly, as the local governing body, has stated its
23 protest in order to allow the Director of AMCO to hold processing of a
24 new restaurant/eating place liquor license, #5758, and restaurant
25 designation permit, under local protest, until the Director receives
26 confirmation from the Municipal Clerk that the conditions in Section 1
27 have been met, and this protest is lifted as authorized by this Assembly
28 Resolution.
29


30 **Section 3.** The Anchorage Assembly hereby authorizes the Municipal Clerk, upon
31 confirmation that all conditions in Section 1 have been met, to provide
32 written notification to AMCO that this protest is lifted without further action
33 by the Assembly.
34

35 PASSED AND APPROVED by the Anchorage Assembly this 23rd day of April, 2019.
36
37

38 
39

40 Chair

41 ATTEST:

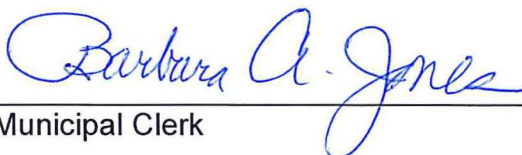42 
43
44
45 Municipal Clerk



THE STATE
of **ALASKA**
GOVERNOR MICHAEL J. DUNLEAVY

Department of Commerce, Community,
and Economic Development

ALCOHOL & MARIJUANA CONTROL OFFICE

550 West Seventh Avenue, Suite 1600
Anchorage, AK 99501
Main: 907.269.0350

March 19, 2019

Municipality of Anchorage
Attn: Miranda Honest
VIA Email: munilicenses@muni.org

License Type:	Restaurant/Eating Place	License Number:	5758
Licensee:	Spoons LLC		
Doing Business As:	Spoonline		
Premises Address:	174 Hightower Road, Girdwood		

☒ **New Application**

☐ **Transfer of Location Application**

☐ **Transfer of Ownership Application**

☐ **Transfer of Controlling Interest Application**

We have received a completed application for the above listed license (see attached application documents) within your jurisdiction. This is the notice required under AS 04.11.480.

A local governing body may protest the approval of an application(s) pursuant to AS 04.11.480 by furnishing the director **and** the applicant with a clear and concise written statement of reasons for the protest within 60 days of receipt of this notice, and by allowing the applicant a reasonable opportunity to defend the application before a meeting of the local governing body, as required by 3 AAC 304.145(d). If a protest is filed, the board will deny the application unless the board finds that the protest is arbitrary, capricious, and unreasonable. To protest the application referenced above, please submit your protest within 60 days and show proof of service upon the applicant.

AS 04.11.491 – AS 04.11.509 provide that the board will deny a license application if the board finds that the license is prohibited under as a result of an election conducted under AS 04.11.507.

AS 04.11.420 provides that the board will not issue a license when a local governing body protests an application on the grounds that the applicant's proposed licensed premises are located in a place within the local government where a local zoning ordinance prohibits the alcohol establishment, unless the local government has approved a variance from the local ordinance.

Sincerely,

Erika McConnell, Director
amco.localgovernmentonly@alaska.gov



Alcohol and Marijuana Control Office
550 W 7th Avenue, Suite 1600
Anchorage, AK 99501
alcohol.licensing@alaska.gov
<https://www.commerce.alaska.gov/web/amco>
Phone: 907.269.0350

Alaska Alcoholic Beverage Control Board

Form AB-00: New License Application

What is this form?

This new license application form is required for all individuals or entities seeking to apply for a new liquor license. Applicants should review **Title 04 of Alaska Statutes** and **Chapter 304 of the Alaska Administrative Code**. All fields of this form must be completed, per AS 04.11.260 and 3 AAC 304.105.

This form must be completed and submitted to AMCO's main office, along with all other required forms and documents, before any license application will be considered complete.

Section 1 – Establishment and Contact Information

Enter information for the business seeking to be licensed.

Licensee:	Spoons LLC		
License Type:	Restaurant or Eating Place	Statutory Reference:	AS 04.11.100
Doing Business As:	Spoonline		
Premises Address:	174 Hightower Rd		
City:	Girdwood	State:	AK
		ZIP:	99587
Local Governing Body:	Municipality of Anchorage		
Community Council:	Girdwood Board of Supervisors		

Mailing Address:	P.O. Box 517		
City:	Girdwood	State:	AK
		ZIP:	99587

Designated Licensee:	Alexandra Fletcher		
Contact Phone:	907-223-9741	Business Phone:	907-783-8122
Contact Email:	Alexandra.spoons@gmail.com		

Seasonal License? ☐ Yes ☒ No ☐ If "Yes", write your six-month operating period: _____

OFFICE USE ONLY			
Complete Date:	3/12/19	License Years:	19/20
Board Meeting Date:	4/29/19	Transaction #:	1014655
Issue Date:		BRE:	





Alaska Alcoholic Beverage Control Board

Form AB-00: New License Application

Section 2 – Premises Information

Premises to be licensed is:

☒

an existing facility

☐

a new building

☐

a proposed building

The next two questions must be completed by beverage dispensary (including tourism) and package store applicants only:

What is the distance of the shortest pedestrian route from the public entrance of the building of your proposed premises to the outer boundaries of the nearest school grounds? Include the unit of measurement in your answer.

What is the distance of the shortest pedestrian route from the public entrance of the building of your proposed premises to the public entrance of the nearest church building? Include the unit of measurement in your answer.

Section 3 – Sole Proprietor Ownership Information

This section must be completed by any sole proprietor who is applying for a license. Entities should skip to Section 4.

If more space is needed, please attach a separate sheet with the required information.

The following information must be completed for each licensee and each affiliate (spouse).

This individual is an:

☐

applicant

☐

affiliate

Name:					
Address:					
City:		State:		ZIP:	

This individual is an:

☐

applicant

☐

affiliate

Name:					
Address:					
City:		State:		ZIP:	



Alaska Alcoholic Beverage Control Board

Form AB-00: New License Application**Section 4 – Entity Ownership Information**

This section must be completed by any entity, including a corporation, limited liability company (LLC), partnership, or limited partnership, that is applying for a license. Sole proprietors should skip to Section 5.

If more space is needed, please attach a separate sheet with the required information.

- If the applicant is a corporation, the following information must be completed for each *stockholder who owns 10% or more* of the stock in the corporation, and for each *president, vice-president, secretary, and managing officer*.
- If the applicant is a limited liability organization, the following information must be completed for each *member with an ownership interest of 10% or more*, and for each *manager*.
- If the applicant is a partnership, including a limited partnership, the following information must be completed for each *partner with an interest of 10% or more*, and for each *general partner*.

Entity Official:	Alexandra Fletcher				
Title(s):	Member	Phone:	907-223-9741	% Owned:	100
Address:	P.O. Box 517				
City:	Girdwood	State:	Alaska	ZIP:	99587

Entity Official:					
Title(s):		Phone:		% Owned:	
Address:					
City:		State:		ZIP:	

Entity Official:					
Title(s):		Phone:		% Owned:	
Address:					
City:		State:		ZIP:	

Entity Official:					
Title(s):		Phone:		% Owned:	
Address:					
City:		State:		ZIP:	



Alcohol and Marijuana Control Office
550 W 7th Avenue, Suite 1600
Anchorage, AK 99501
alcohol.licensing@alaska.gov
<https://www.commerce.alaska.gov/web/amco>
Phone: 907.269.0350

Alaska Alcoholic Beverage Control Board

Form AB-00: New License Application

This subsection must be completed by any applicant that is a corporation or LLC. Corporations and LLCs are required to be in good standing with the Alaska Division of Corporations (DOC) and have a registered agent who is an individual resident of the state of Alaska.

DOC Entity #:	10009776	AK Formed Date:	01/08/2013	Home State:	Alaska
Registered Agent:	Alexandra Fletcher	Agent's Phone:	907-233-9741		
Agent's Mailing Address:	P.O. Box 517				
City:	Girdwood	State:	Alaska	ZIP:	99587

Residency of Agent: Yes No

Is your corporation or LLC's registered agent an individual resident of the state of Alaska?

☒ ☐

Section 5 – Other Licenses

Ownership and financial interest in other alcoholic beverage businesses: Yes No

Does any representative or owner named in this application have any direct or indirect financial interest in any other alcoholic beverage business that does business in or is licensed in Alaska?

☐ ☒

If "Yes", disclose which individual(s) has the financial interest, what the type of business is, and if licensed in Alaska, which license number(s) and license type(s):

Section 6 – Authorization

Communication with AMCO staff: Yes No

Does any person other than a licensee named in this application have authority to discuss this license with AMCO staff?

☒ ☐

If "Yes", disclose the name of the individual and the reason for this authorization:

Ashley Wade: She is helping me with the application process.





Alcohol and Marijuana Control Office

550 W 7th Avenue, Suite 1600

Anchorage, AK 99501

alcohol.licensing@alaska.gov

<https://www.commerce.alaska.gov/web/amco>

Phone: 907.269.0350

Alaska Alcoholic Beverage Control Board

Form AB-00: New License Application

Section 7 – Certifications

Read each line below, and then sign your initials in the box to the right of each statement:

Initials

I certify that all proposed licensees (as defined in AS 04.11.260) and affiliates have been listed on this application.

AMK

I certify that all proposed licensees have been listed with the Division of Corporations.

AMK

I certify that I understand that providing a false statement on this form or any other form provided by AMCO is grounds for rejection or denial of this application or revocation of any license issued.

AMK

I certify that all licensees, agents, and employees who sell or serve alcoholic beverages or check the identification of a patron will complete an approved alcohol server education course, if required by AS 04.21.025, and, while selling or serving alcoholic beverages, will carry or have available to show a current course card or a photocopy of the card certifying completion of approved alcohol server education course, if required by 3 AAC 304.465.

AMK

I agree to provide all information required by the Alcoholic Beverage Control Board in support of this application.

AMK

As an applicant for a liquor license, I declare under penalty of perjury that I have read and am familiar with AS 04 and 3 AAC 304, and that this application, including all accompanying schedules and statements, is true, correct, and complete.

Signature of licensee

Alexandra Fletcher, Spoons LLC



Printed name of licensee

Signature of Notary Public

Notary Public in and for the State of Alaska

My commission expires: May 16 2022

Subscribed and sworn to before me this 5 day of March, 20 19.

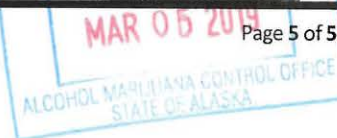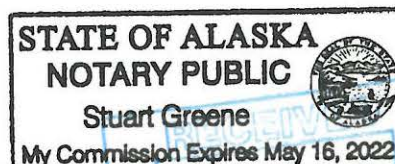



Alaska Alcoholic Beverage Control Board

Form AB-02: Premises Diagram**What is this form?**

A detailed diagram of the proposed licensed premises is required for all liquor license applications, per AS 04.11.260 and 3 AAC 304.185. Your diagram must include dimensions and must show all entrances and boundaries of the premises, walls, bars, fixtures, and areas of storage, service, consumption, and manufacturing. If your proposed premises is located within a building or building complex that contains multiple businesses and/or tenants, please provide an additional page that clearly shows the location of your proposed premises within the building or building complex, along with the addresses and/or suite numbers of the other businesses and/or tenants within the building or building complex.

The second page of this form is not required. Blueprints, CAD drawings, or other clearly drawn and marked diagrams may be submitted in lieu of the second page of this form. The first page must still be completed, attached to, and submitted with any supplemental diagrams. An AMCO employee may require you to complete the second page of this form if additional documentation for your premises diagram is needed.

This form must be completed and submitted to AMCO's main office before any license application will be considered complete.


Yes No

I have attached blueprints, CAD drawings, or other supporting documents in addition to, or in lieu of, the second page of this form.

**Section 1 – Establishment Information**

Enter information for the business seeking to be licensed, as identified on the license application.

Licensee:	Spoons LLC	License Number:	
License Type:	Restaurant or Eating Place		
Doing Business As:	Spoonline		
Premises Address:	174 Hightower Rd		
City:	Girdwood	State:	Alaska
		ZIP:	99587

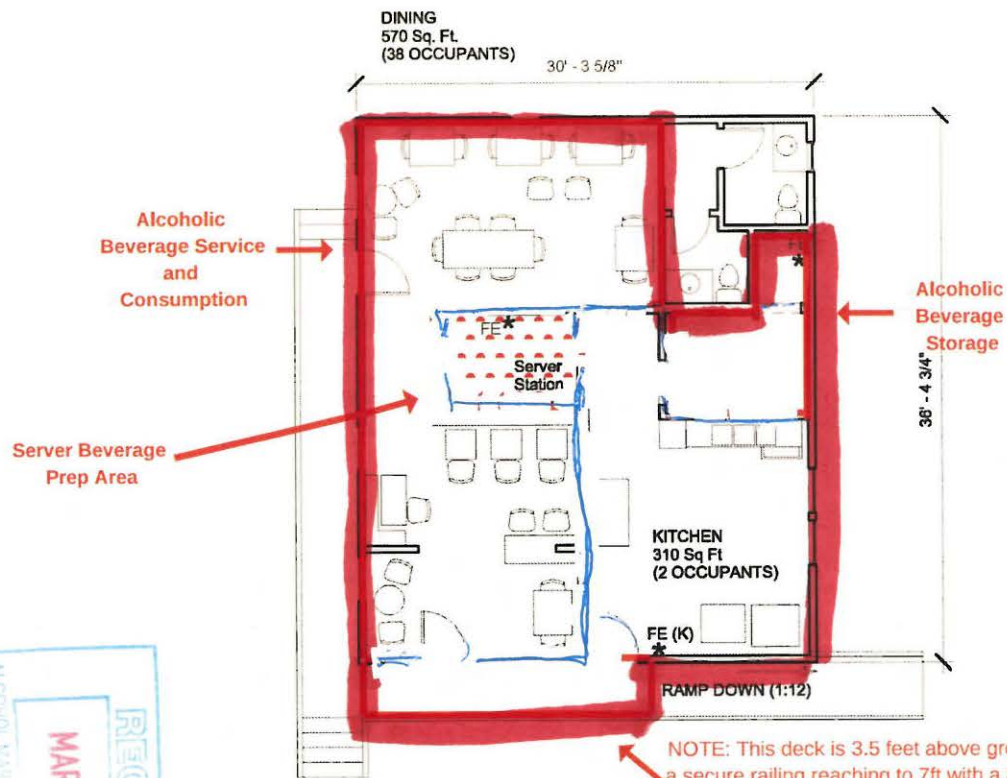

IBC 2012 Code Review

Previous Use: B-Office and F-1 Commercial Kitchen
Current Use: F-1 Commercial Kitchen and A-2 Restaurant

Building was constructed in 1999 and is non-sprinklered.

Per Table 503

Construction Type, VB

A-2 Occupancy: Allowable Stories = 1, Allowable Area = 6,000

B Occupancy: Allowable Stories = 2, Allowable Area = 9,000

F-1 Occupancy: Allowable Stories = 1, Allowable Area = 8,500

Occupancy Separation per Table 508.4 = 2hrs for Non-Sprinklered bldg.
Per 508.3 Non-Separated Uses no separation required.

Max Building Area per most restrictive use (A-2) 6,000 and Maximum 1 Story.
Building is 1 story and 1,081 Sq. Ft. Total

Uses:

Business Areas: 1 Occupant per 100 sq ft gross

Kitchen: 1 Occupant per 200 sq ft gross

Dining Seating: Unconcentrated tables and chairs 1 occupant per 15 sq ft net

Total Occupants: 40

Number of Exits = 3

1 SPOONLINE FLOOR PLAN
1/8" = 1'-0"

Alex Fletcher::Spoonline
Interior Modifications

As-Built Floor Plan

Project number 18-001

Date Feb 25, 2019


Drawn by KMZ

Checked by KMZ

A1.1

Full Size at 11x17 Sheet

RECEIVED
MAR 05 2019
ALCOHOL WAIVER/ALCOHOL SERVICE
STATE OF ALASKA

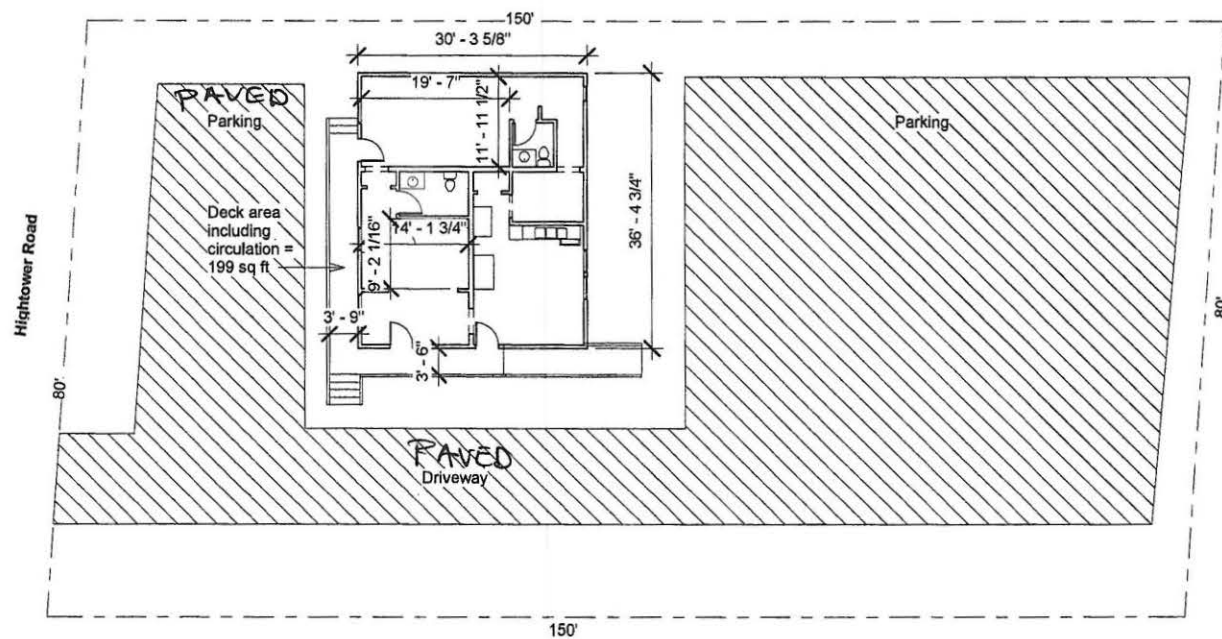

① SPOONLINE SITE PLAN
1/16" = 1'-0"



Alex Fletcher::Spoonline
Interior Modifications

SITE PLAN DIAGRAM

Project number	18-001
Date	July 24, 2018
Drawn by	Author
Checked by	Checker

A1.2



Alaska Alcoholic Beverage Control Board

Form AB-03: Restaurant Designation Permit Application

What is this form?

A restaurant designation permit application is required for a licensee desiring designation under 3 AAC 304.715 – 3 AAC 304.795 as a bona fide restaurant, hotel, or eating place for purposes of AS 04.16.010(c) or AS 04.16.049. Designation will be granted only to a holder of a beverage dispensary, club, recreational site, golf course, or restaurant or eating place license, and only if the requirements of 3 AAC 304.305, 3 AAC 304.725, and 3 AAC 304.745, as applicable, are met. A **detailed floor plan** of the proposed designated and undesignated areas of the licensed business and a **menu** or expected menu listing the meals to be offered to patrons must accompany this form. Applicants should review AS 04.16.049 – AS 04.16.052 and 3 AAC 304.715 – 3 AAC 304.795. All fields of this form must be completed. The required \$50 permit fee may be made by credit card, check, or money order.

Section 1 – Establishment Information

Enter information for licensed establishment.

Licensee:	Spoons LLC				
License Type:	Restaurant or Eating Place	License Number:	10009776-5758		
Doing Business As:	Spoonline				
Premises Address:	174 Hightower Rd				
City:	Girdwood	State:	AK	ZIP:	99587
Contact Name:	Alexandra Fletcher	Contact Phone:	907-783-8122		

Section 2 – Type of Designation Requested

This application is for the request of designation as a bona fide restaurant, hotel, or eating place for purposes of AS 04.16.010(c) or AS 04.16.049, and for the request of the following designation(s) (check all that apply):

- ☐ Dining after standard closing hours: AS 04.16.010(c)
- ☒ Dining by persons 16 – 20 years of age: AS 04.16.049(a)(2)
- ☒ Dining by persons under the age of 16 years, accompanied by a person over the age of 21: AS 04.16.049(a)(3)
- ☐ Employment for persons 16 or 17 years of age: AS 04.16.049(c)

NOTE: Under AS 04.16.049(d), this permit is not required to employ a person 18 - 20 years of age.

OFFICE USE ONLY				
Issue Date:		Transaction #:	1014655	BRE: MAR 05 2019



Alaska Alcoholic Beverage Control Board

Form AB-03: Restaurant Designation Permit Application

Section 3 – Additional Information

Enter all hours that your establishment intends to be open. Include variances in weekend/weekday hours, and indicate am/pm:

10am-11pm

Are any forms of entertainment offered or available within the licensed business or on the proposed designated portions of the premises?

Yes

☐

No

☒

If "Yes", describe the entertainment offered or available:

Food and beverage service offered or anticipated is:

☒

table service

☐

buffet service

☐

counter service

☐

other

If "other", describe the manner of food and beverage service offered or anticipated:

Is an owner, manager, or assistant manager 21 years of age or older always present on the premises during business hours?

Yes

☒

No

☐


Blueprints, CAD drawings, or other clearly drawn and marked diagrams may be submitted in lieu of the third page of this form.


I have attached blueprints, CAD drawings, or other supporting documents in addition to, or in lieu of, the third page of this form that meet the requirements of this form.

Yes

☒

No

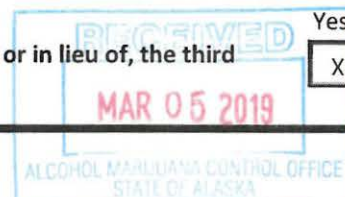☐

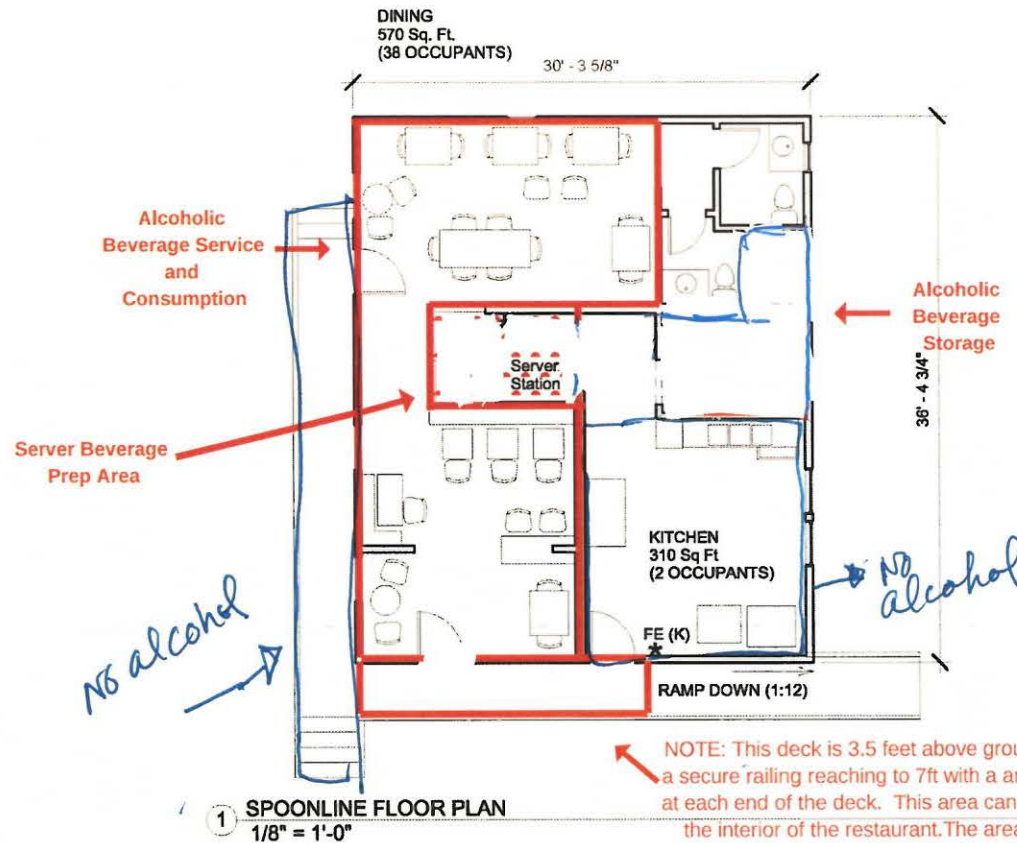

IBC 2012 Code Review

Previous Use: B-Office and F-1 Commercial Kitchen
Current Use: F-1 Commercial Kitchen and A-2 Restaurant

Building was constructed in 1999 and is non-sprinklered.

Per Table 503

Construction Type, VB

A-2 Occupancy: Allowable Stories = 1, Allowable Area = 6,000

B Occupancy: Allowable Stories = 2, Allowable Area = 9,000

F-1 Occupancy: Allowable Stories = 1, Allowable Area = 8,500

Occupancy Separation per Table 508.4 = 2 hrs for Non-Sprinklered bldg.
Per 508.3 Non-Separated Uses no separation required.

Max Building Area per most restrictive use (A-2) 6,000 and Maximum 1 Story.
Building is 1 story and 1,081 Sq. Ft. Total

Uses:

Business Areas: 1 Occupant per 100 sq ft gross

Kitchen: 1 Occupant per 200 sq ft gross

Dining Seating: Unconcentrated tables and chairs 1 occupant per 15 sq ft net

Total Occupants: 40

Number of Exits = 3

NOTE: This deck is 3.5 feet above ground level, and there is a secure railing reaching to 7ft with an emergency exit gate at each end of the deck. This area can only be entered from the interior of the restaurant. The area will be served and monitored by TAPS certified servers. The front deck will not be used for service.

Alex Fletcher:::Spoonline
Interior Modifications

Dining for under 21
within red outline.

As-Built Floor Plan

Project number 18-001
Date Feb 25, 2019
Drawn by KMZ
Checked by KMZ

A1.1

Full Size at 11x17 Sheet



Alaska Alcoholic Beverage Control Board

Form AB-03: Restaurant Designation Permit Application

Section 5 – Certifications and Approvals

Read each line below, and then sign your initials in the box to the right of each statement:

Initials

I have included with this form a detailed floor plan of the proposed designated and undesignated areas of the licensed business for purposes of this application. I understand that this diagram is different than my licensed premises diagram.

AMF

I have included with this form a menu, or an expected menu, listing the meals to be offered to patrons.

AMF

I certify that the license for which I am requesting designation is either a beverage dispensary, club, recreational site, golf course, or restaurant or eating place license.

AMF


I declare under penalty of perjury that this form, including all attachments and accompanying schedules and statements, is true, correct, and complete.

Signature of licensee

Alexandra Fletcher

Printed name of licensee

Signature of Notary Public

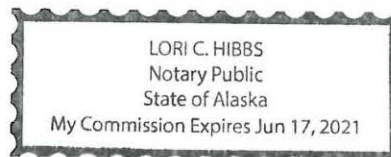Notary Public in and for the State of AlaskaMy commission expires: 6-17-2021Subscribed and sworn to before me this 20th day of December, 2018.

Local Government Review (to be completed by an appropriate local government official):

Approved

Disapproved

☐☐

Signature of local government official

Date

Printed name of local government official

Title

AMCO



Alaska Alcoholic Beverage Control Board

Form AB-03: Restaurant Designation Permit Application

AMCO Enforcement Review:

Signature of AMCO Enforcement Supervisor

Printed name of AMCO Enforcement Supervisor

Enforcement Recommendations:

AMCO Director Review:

Approved Disapproved

☐☐

Signature of AMCO Director

Printed name of AMCO Director

Date

Limitations:

spoonline

LUNCH MENU

SANDWICHES

Served with dilly beans or fruit

MEXI VEGGIE

Sweet bell peppers, avocado, carrots, scallions, spinach and cheddar served with salsa cream cheese on a croissant – delicious toasted. 10

MEXI TURKEY

Add roasted turkey to the deliciousness above. 11

HEHNLIN

The hardest working sandwich in town! Pastrami and kimchi on a ciabatta with dijon cream cheese topped with 2 slices of swiss and served hot. 12

REBECCA'S REUBEN

Roasted turkey and Russian dressing with melted swiss and napa cabbage slaw, served hot. 10
Sub pastrami add 2

CHUGACH CHICKEN CROISSANT

Juicy chicken salad with cranberries and organic apples in a creamy lemon dressing. 11

TURKEY BACON MELT

Toasted ciabatta with creamy dijon, turkey, chile bacon, Havarti cheese and spinach served hot. 12

APPLE AND BRIE CROISSANT

Thinly sliced organic apples, creamy brie and sweet apple mustard with or without spinach.

Great melted! 10

Add Bacon or Ham 2

VEGELISCIOUS WRAP

Carrot hummus spread on a flour tortilla with all the freshest veggies (vegan). 10

OR ...

design your own- Gluten free bread, tortilla wrap, oatnut bread, croissant, ciabatta, lettuce wrap. 10-12

SALADS

BABY SPINACH SALAD

Baby spinach with roasted beets & vegetables, tossed with lemon vinaigrette and topped with toasted pecans. 12

GARDEN SALAD

Our freshest veggies and your choice of dressing 11

CHEF'S SALAD

Crisp romaine, turkey, ham, hard boiled eggs and cheddar cheese. 14

Salad dressings - choose from our housemade lemon vinaigrette, Russian caper or Ranch.

Add roasted chicken or chevre to any salad. 4

SOUPS

HARVEST SOUP

Carrot, coconut milk, sweet potato, ginger and apple (vegan). 8

SOUP OF THE DAY - ask at the counter. 8

DRINKS


Pellegrino mineral water 2

La Croix 2.5

Izze 2.5

Peligrino limonata/orangina 2.5

Juice box 1.5

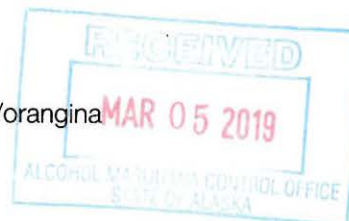

Spoonline
Dinner menu draft

Snacks

3pm-5pm

Keto pizzettas – prosciutto and fig

Margharita – tomato, fresh mozzarella& basil

Salami and kalamata

Ploughman's board - aged cheddar, baguette, pate, whole grain mustard and apple

Mezze platter - spicy carrot hummus, babaganoush, falafel, pita, olives, marinated feta

Roasted cauliflower florets with harissa aioli

Dinner


5pm-9pm

salads

- Classic Caesar dressing on grilled romaine with house made croutons 8
- Roasted beet and butternut squash spinach salad with pesto vinaigrette and chevre 10
- Caprese salad on mixed greens 8
add bacon or chicken 4

entrees – all are served with seasonal vegetables

- Beef bourguignon pot pie~ like Julia's but served encroute and topped with puff pastry 22
- Vegan yellow curry with cauliflower and roasted peppers over rice noodles or on a bed of spinach 16

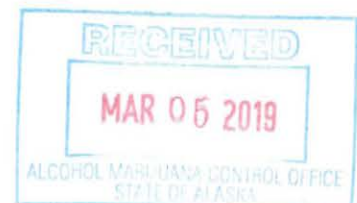

Add chicken or pulled pork 4

- Hen&Waffle ~ half an herb roasted Cornish game hen served on a savory thyme cheddar waffle with roasted garlic velouté 26
- Double thick bone in pepper crusted pork chop with grilled apples and mint gastrique served with smashed potatoes 32
- Sake marinated black cod broiled and served in shiso broth with house made shrimp wontons 28





MUNICIPALITY OF ANCHORAGE

Assembly Information Memorandum

No. AIM 51 - 2019

Meeting Date: April 23, 2019

From: CHAIR

Subject: AR 2109-133, A RESOLUTION OF THE ANCHORAGE MUNICIPAL ASSEMBLY STATING ITS PROTEST REGARDING A NEW RESTAURANT/ EATING PLACE LIQUOR LICENSE, #5758, AND RESTAURANT DESIGNATION PERMIT, FOR SPOONS, LLC DBA SPOONLINE LOCATED AT 174 HIGHTOWER RD., GIRDWOOD, AK 99587 AND AUTHORIZING THE MUNICIPAL CLERK TO TAKE CERTAIN ACTION.

Attached for the Assembly's review, is a letter of non-objection from the Girdwood Community Council regarding the application for a new restaurant/eating place liquor license, #5758, for Spoonline.

Prepared by: Mandy Honest, Business License Official
Approved by: Barbara A. Jones, Municipal Clerk
Respectfully submitted: Felix Rivera, Assembly Chair

**Municipality
of
Anchorage**



P.O. Box 390
Girdwood, Alaska 99587
<http://www.muni.org/gbos>
Ethan Berkowitz, Mayor

GIRDWOOD VALLEY SERVICE AREA BOARD OF SUPERVISORS
Jerry Fox & Robert Snitzer, Co-Chairs
Eryn Boone, Mike Edgington, Christina Hendrickson

LETTER OF NON-OBJECTION

Spoons LLC dba Spoonline
Alexandra Fletcher, Owner

RE: Spoonline Beer and Wine License #5758

The Girdwood Board of Supervisors (GBOS), by a vote of 4 to 0 at the April 15, 2019 GBOS Regular Meeting, has no objection to approval of the New Application Restaurant or Eating Place Liquor License #5758 for Spoonline, an existing restaurant extending operations for dinner service in 2019 at 174 Hightower Road.

This action was supported by the Land Use Committee at their Regular Meeting on April 8, 2019 with a vote of 10 in favor, 0 opposed and 2 abstentions.

Non-Objection is based on the following:

Two restaurants with beer/wine licenses have closed in recent years and only one has been replaced.

More locations for dinner service with beer/wine will provide more options to community and to visitors, particularly on busy days and seasons.

Having a beer/wine license will be helpful in adding to the revenue stream for the business.


Mike Edgington, GBOS Land Use Supervisor

4/17/19
Date


Witness